


NOTES :

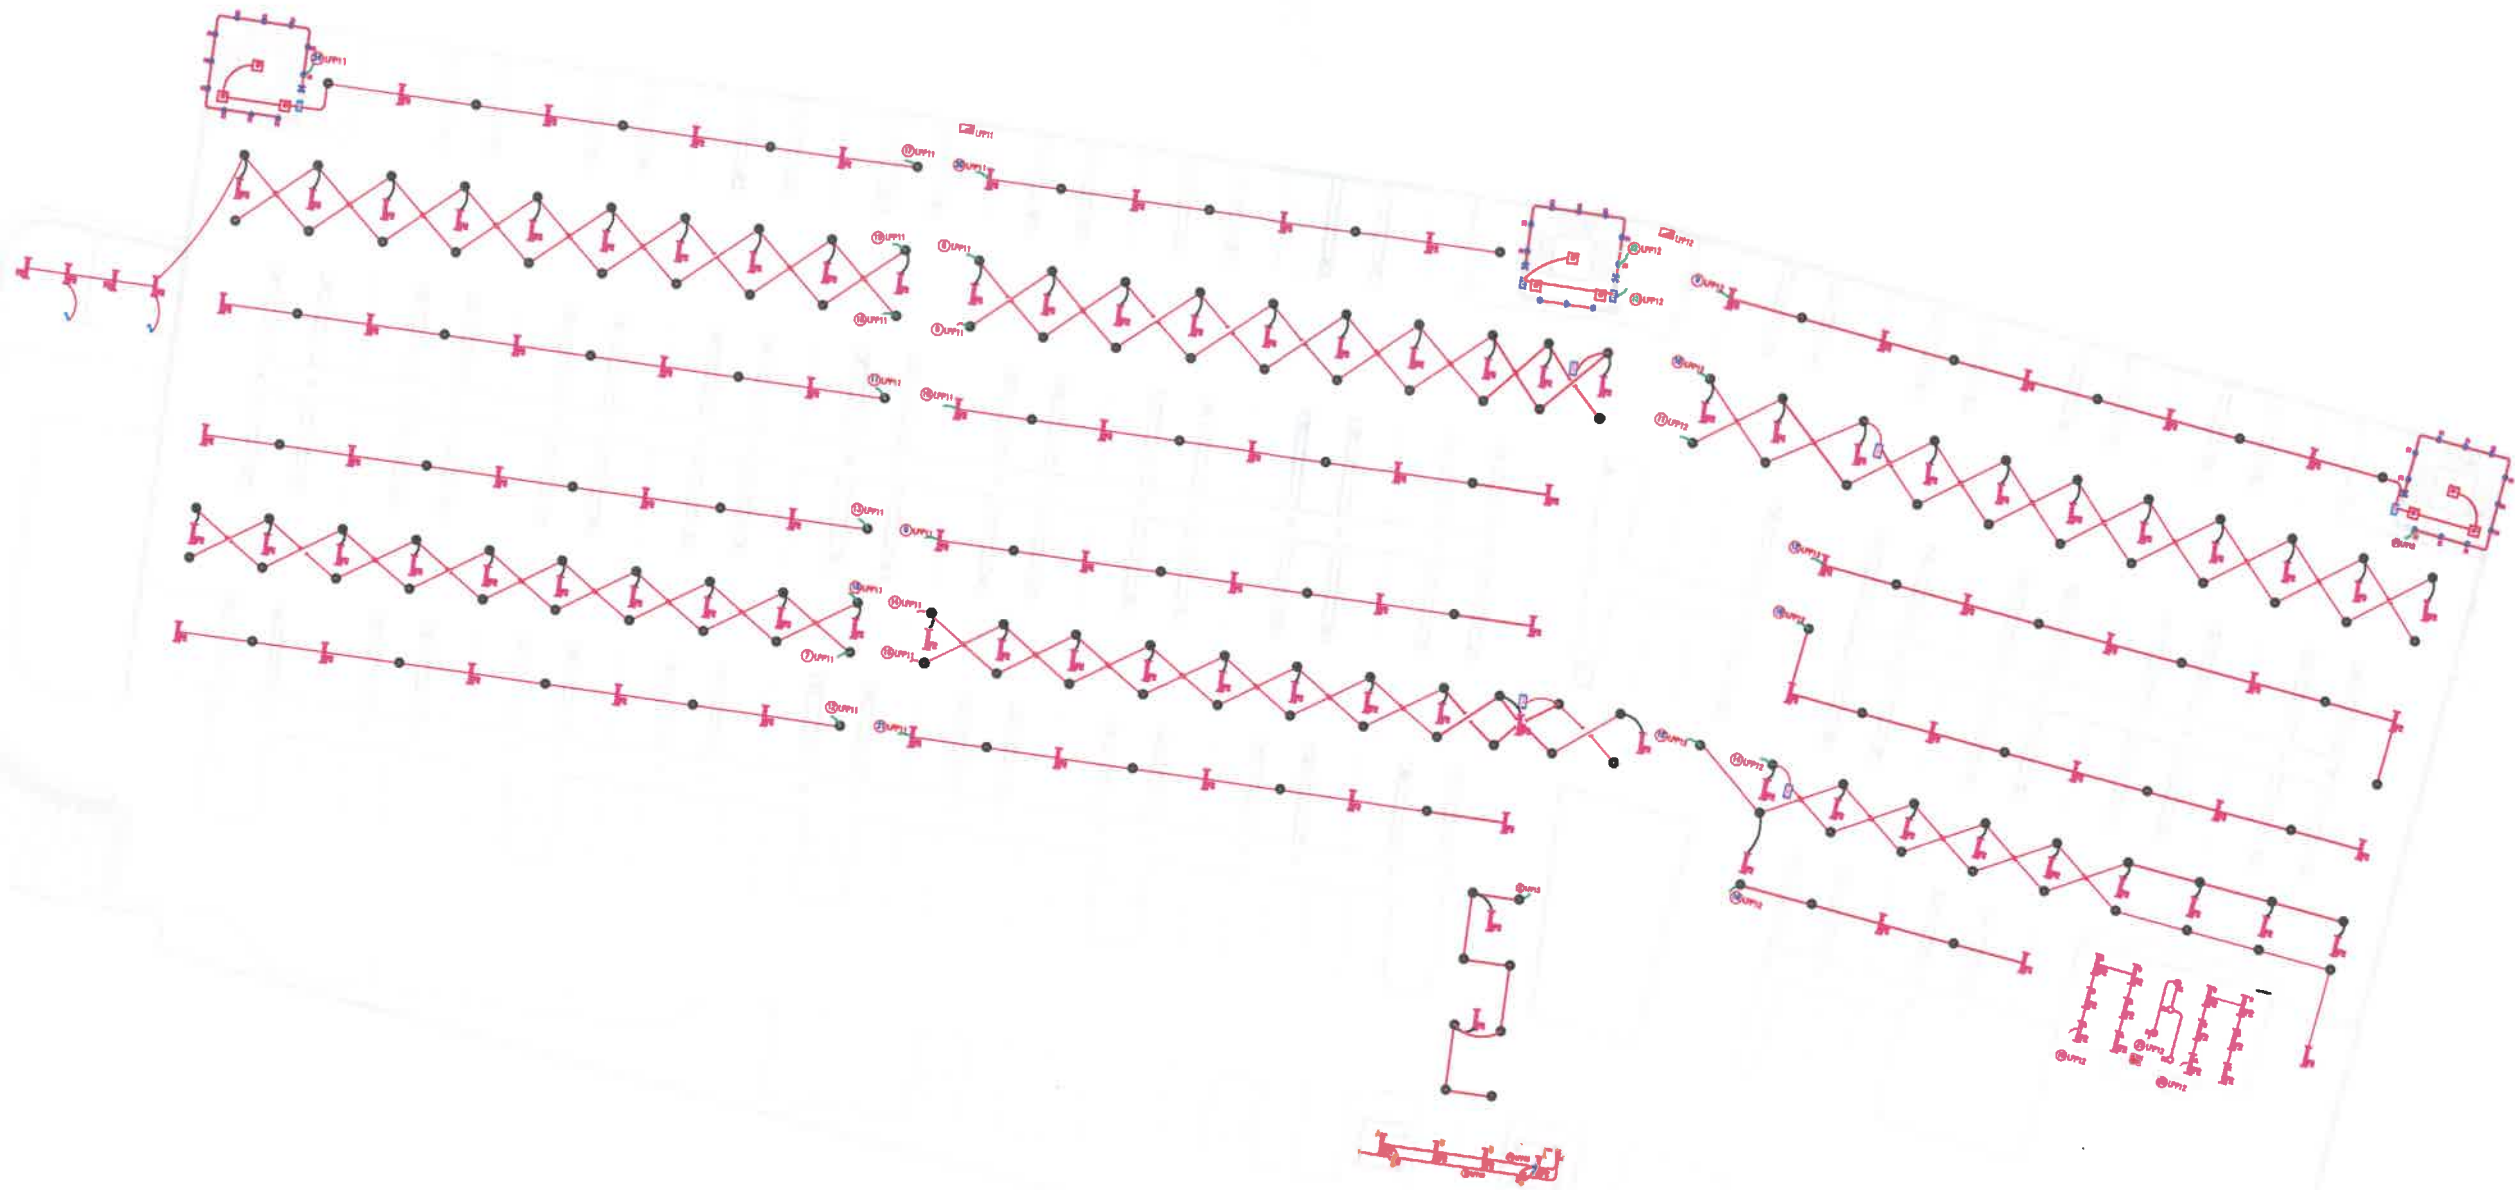

REV. NO.	DATE	DESCRIPTION

PROJECT OWNER :  
THE GERMAN JORDANIAN UNIVERSITY

PROJECT NAME :  
PARKING C

DRAWING NAME :  
LIGHTING FIXTURES PROPOSED DESIGN


Prepared By :  
MAINTAINANCE DEPARTMENT




DESIGNED BY	
CHECKED BY	
DRAWN BY	

SCALE: \_\_\_\_\_ SHEET SIZE: \_\_\_\_\_

PLOT NO.	SHEET NO.	TOTAL
116	1 of 0000	000000

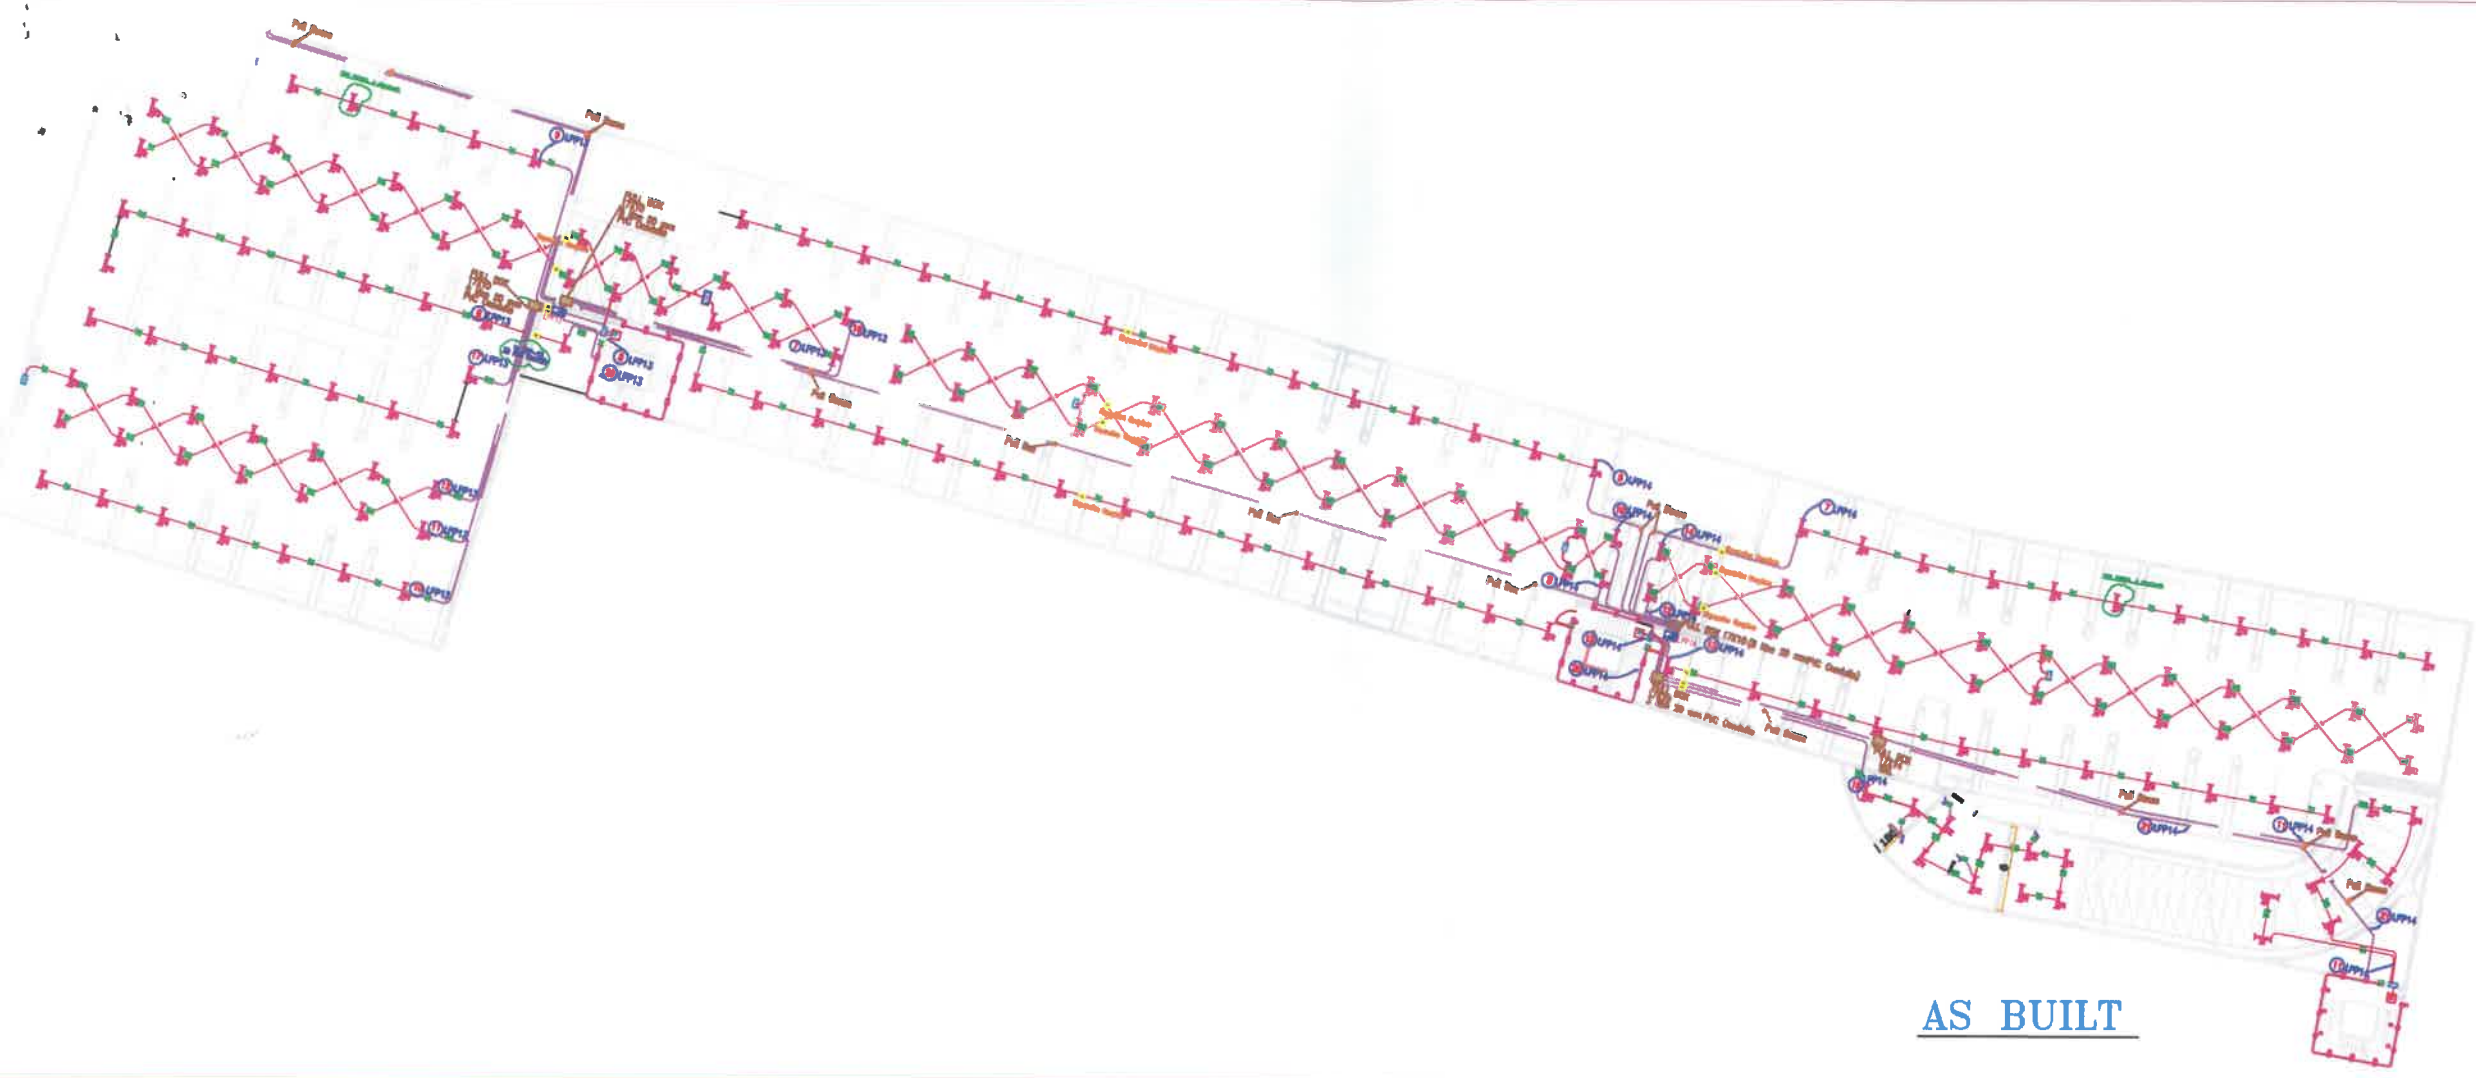

AS BUILT

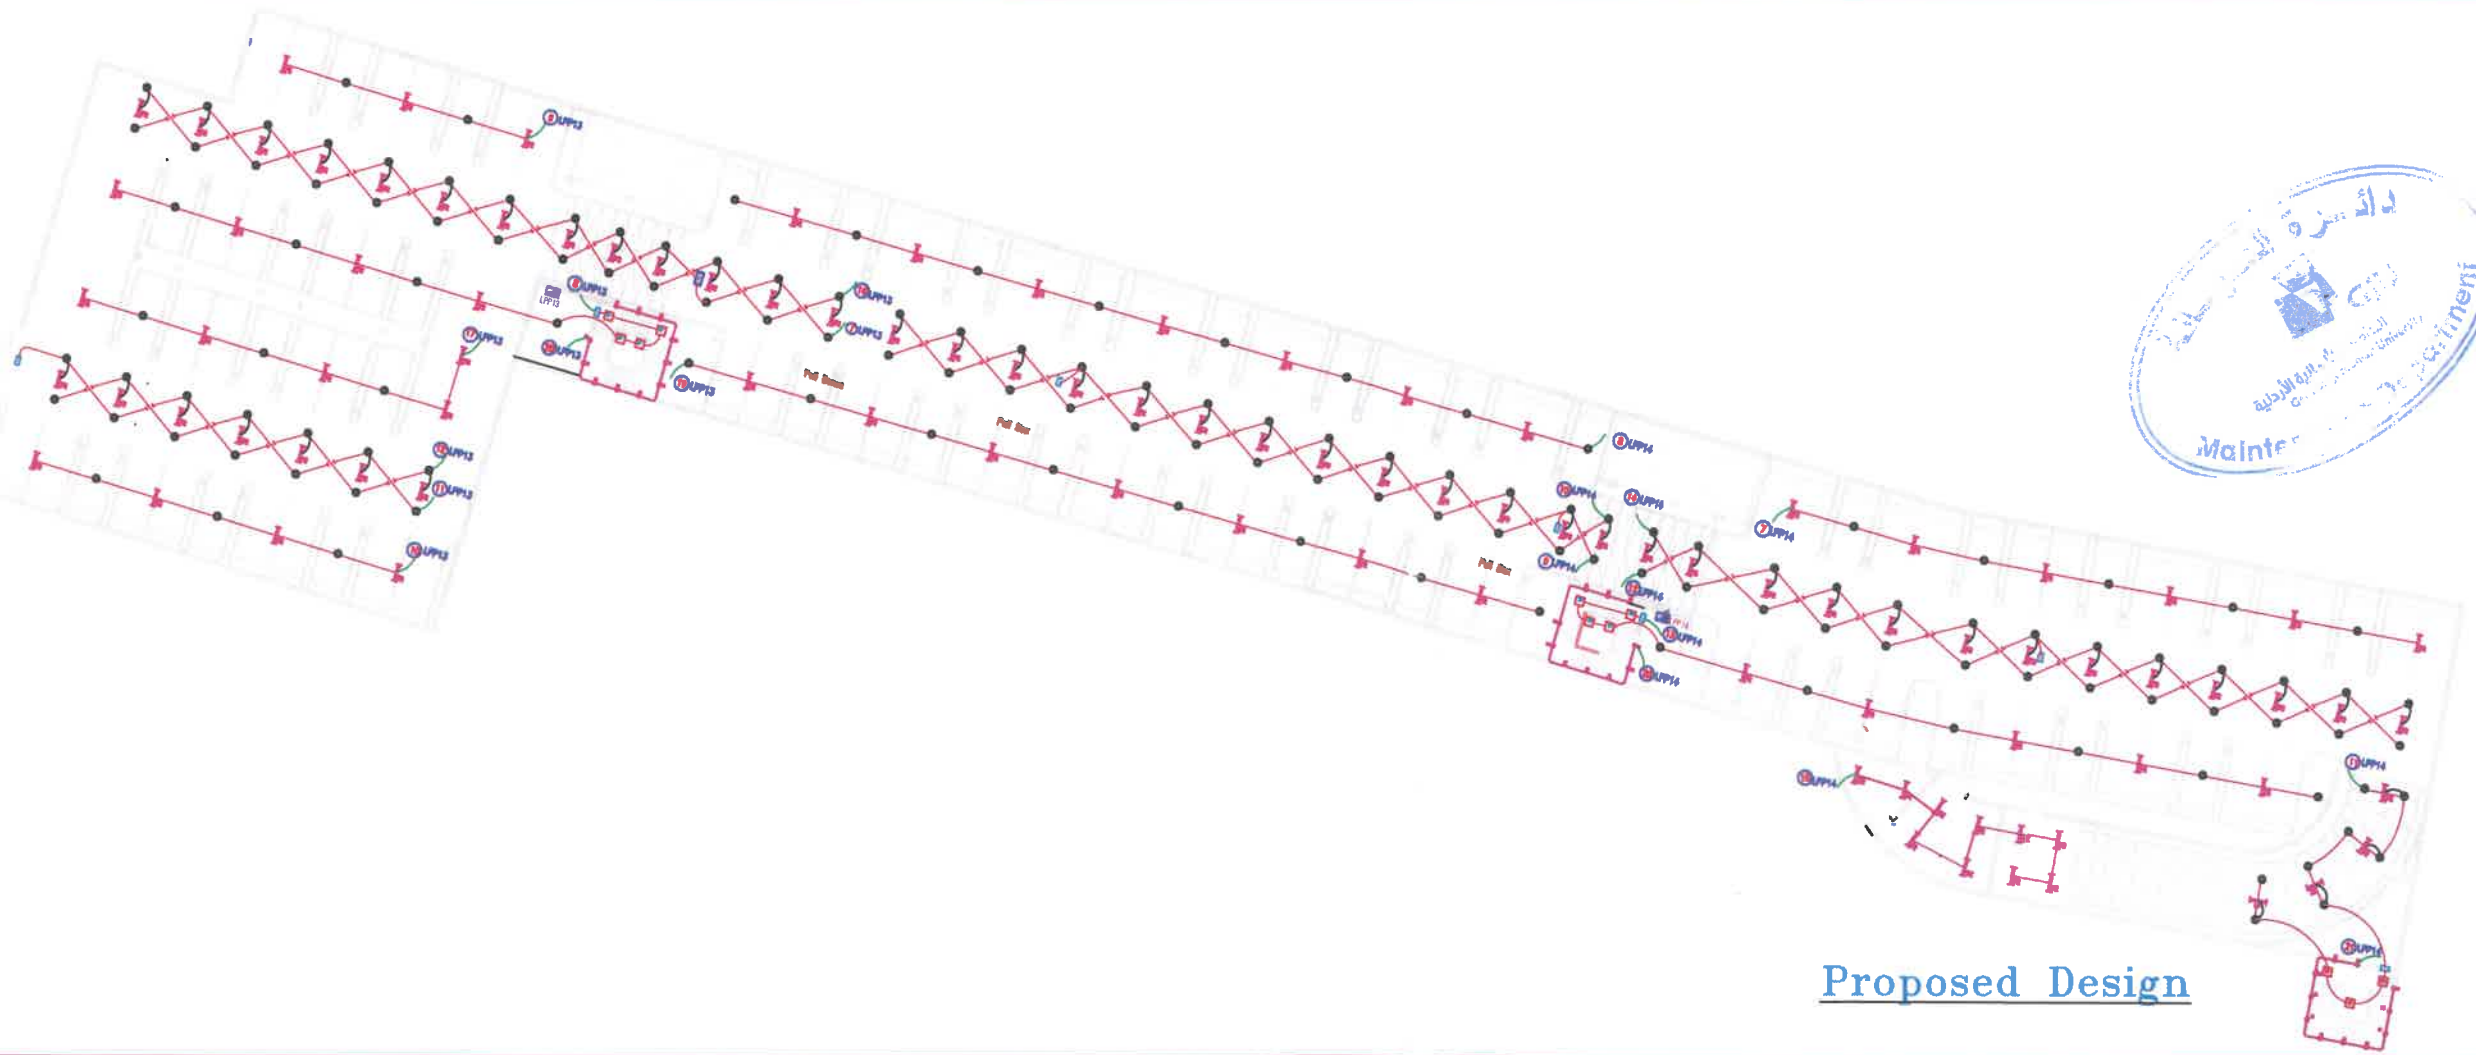

Proposed Design

NOTES :

REV. NO.	DATE	DESCRIPTION

PROJECT OWNER :  
THE GERMAN JORDANIAN UNIVERSITY

PROJECT NAME :  
PARKING A

DRAWING NAME :  
LIGHTING FIGURES


Prepared By :  
MAINTAINANCE DEPARTMENT

DESIGNED BY	
CHECKED BY	
DRAWN BY	

SCALE: \_\_\_\_\_ SHEET SIZE: \_\_\_\_\_

PLOT NO.	SHEET NO.	TOTAL
118	1 of 0000	0000

NOTES :

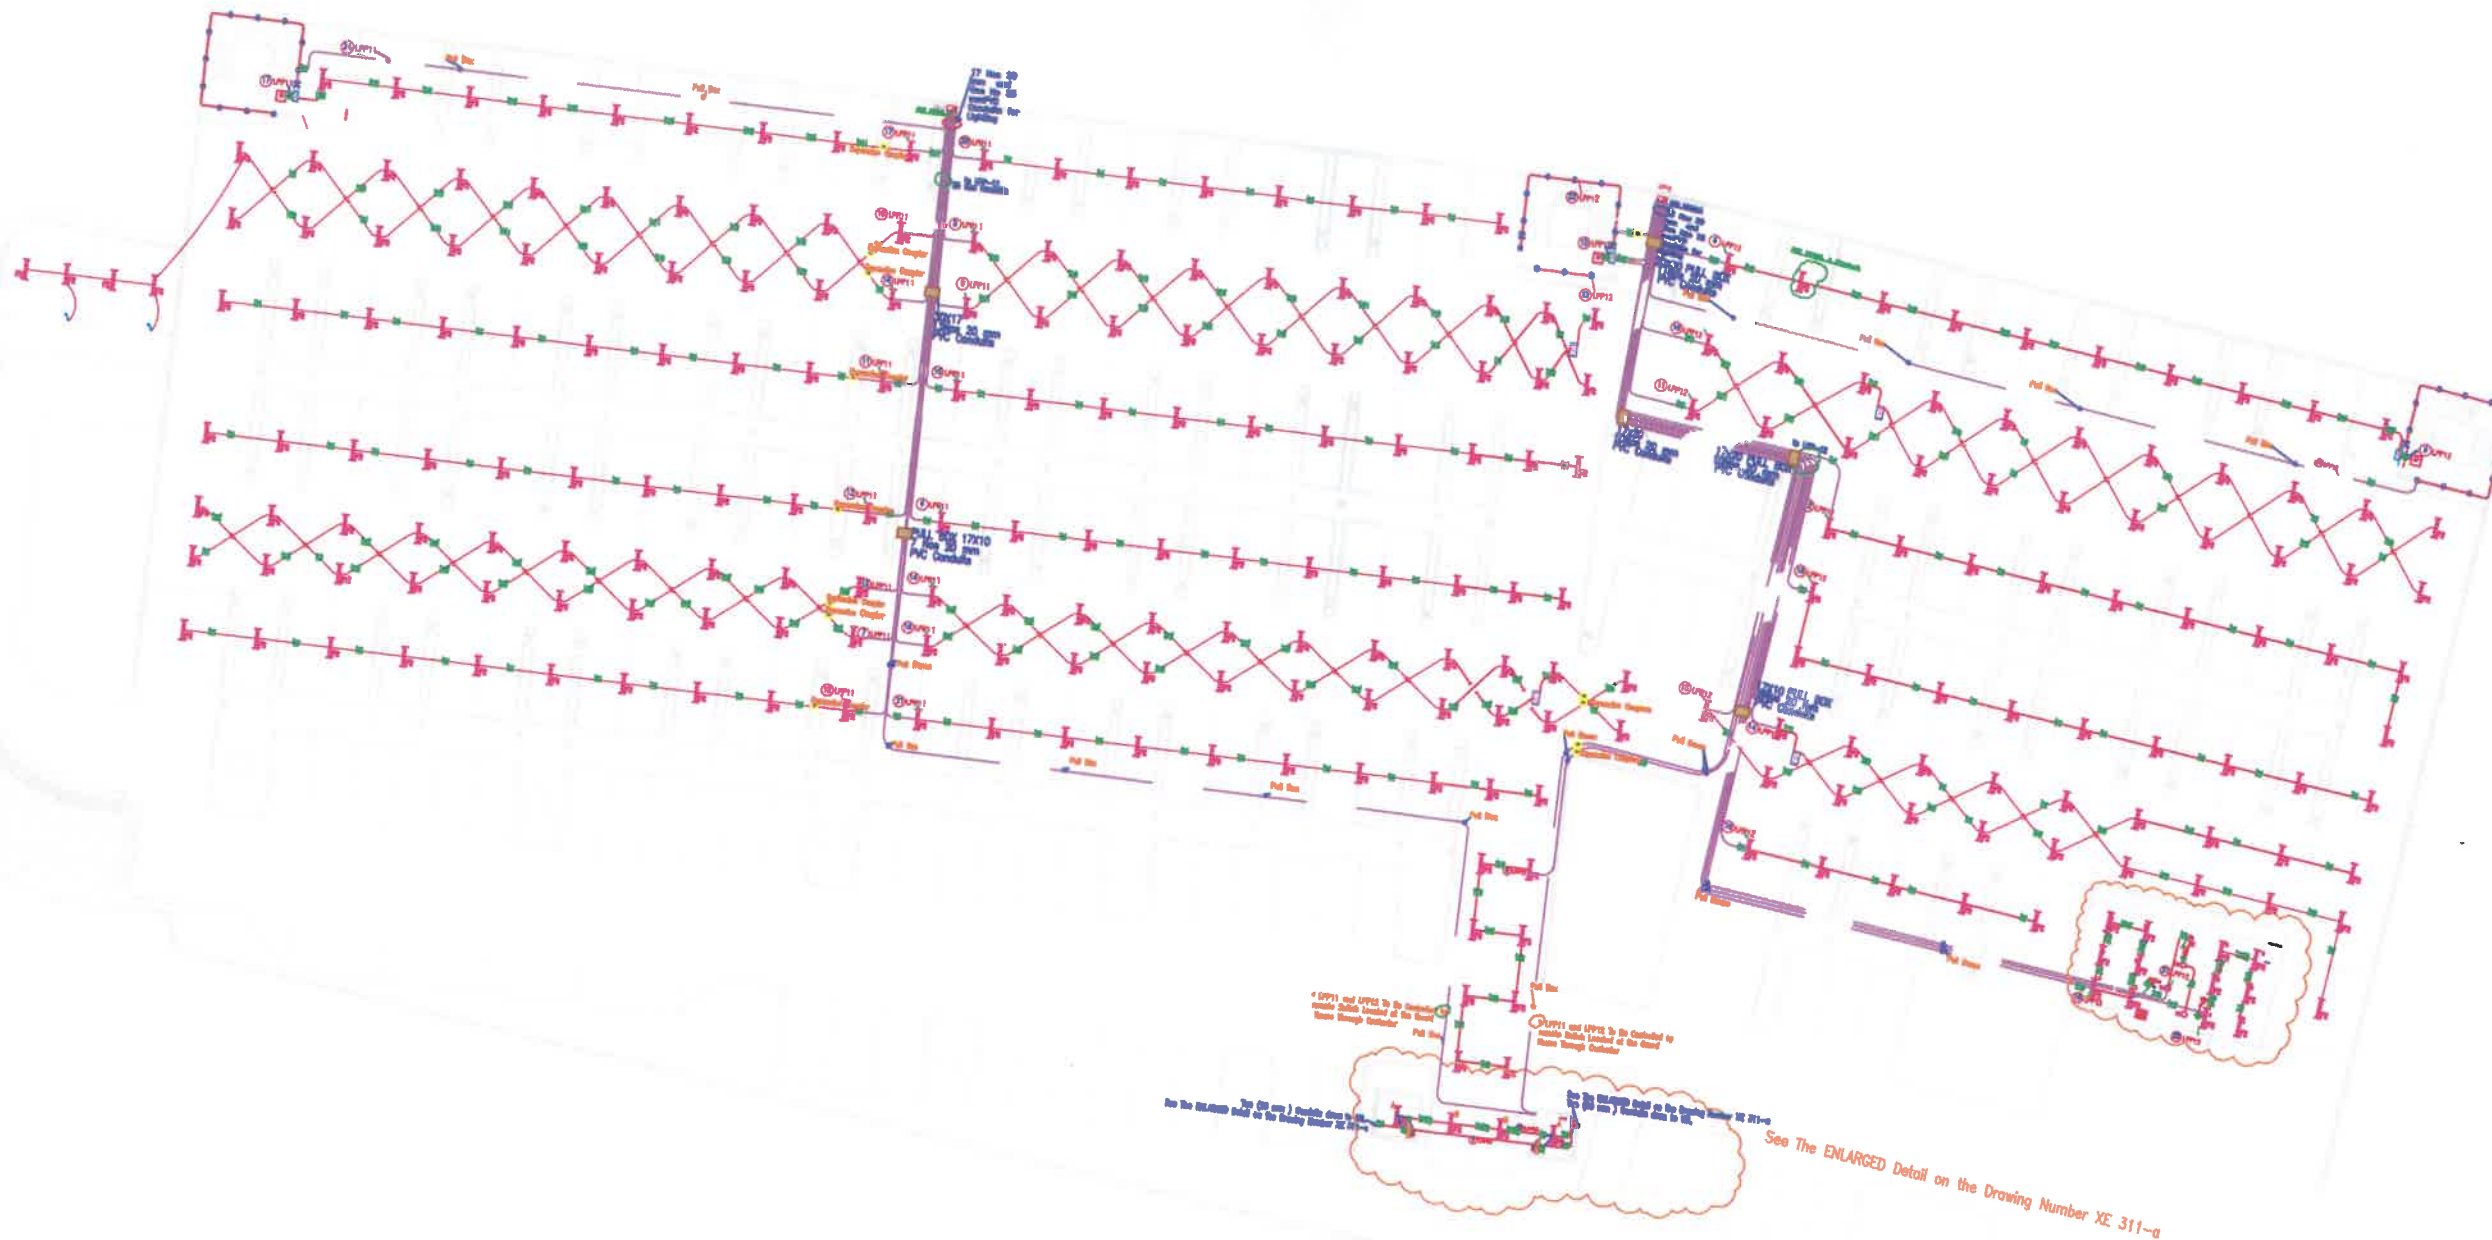

REV. NO.	DATE	DESCRIPTION

PROJECT OWNER :  
THE GERMAN JORDANIAN UNIVERSITY

PROJECT NAME :  
PARKING C

DRAWING NAME :  
LIGHTING FIXTURES AS BUILT

Prepared By :  
MAINTAINANCE DEPARTMENT



DESIGNED BY	
CHECKED BY	
DRAWN BY	

SCALE: \_\_\_\_\_

PLAT NO.	PLANN NO.	YUEN
116	1 of several	