




 الجامعة الأردنية
 Jordanian University
 عمان - الأردن
 Amman - Jordan



Client

 Client
 German Jordanian
 University
 AMMAN - JORDAN

As Built -Prefab D
 Scale
 N.T.S
 E01


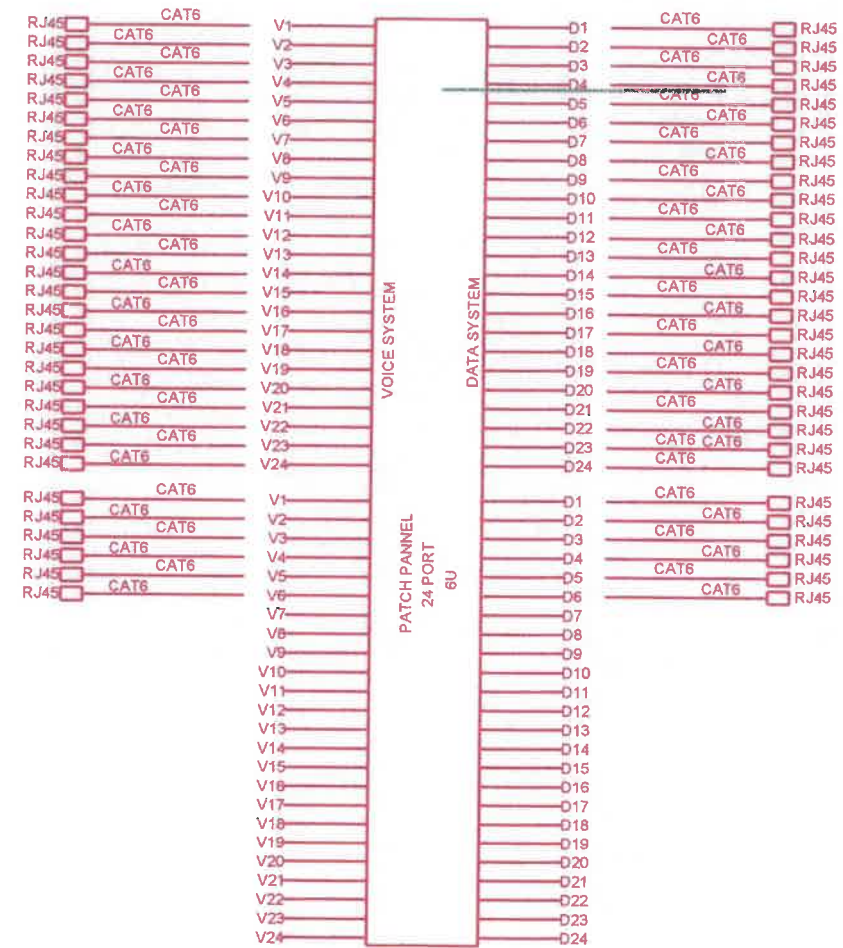
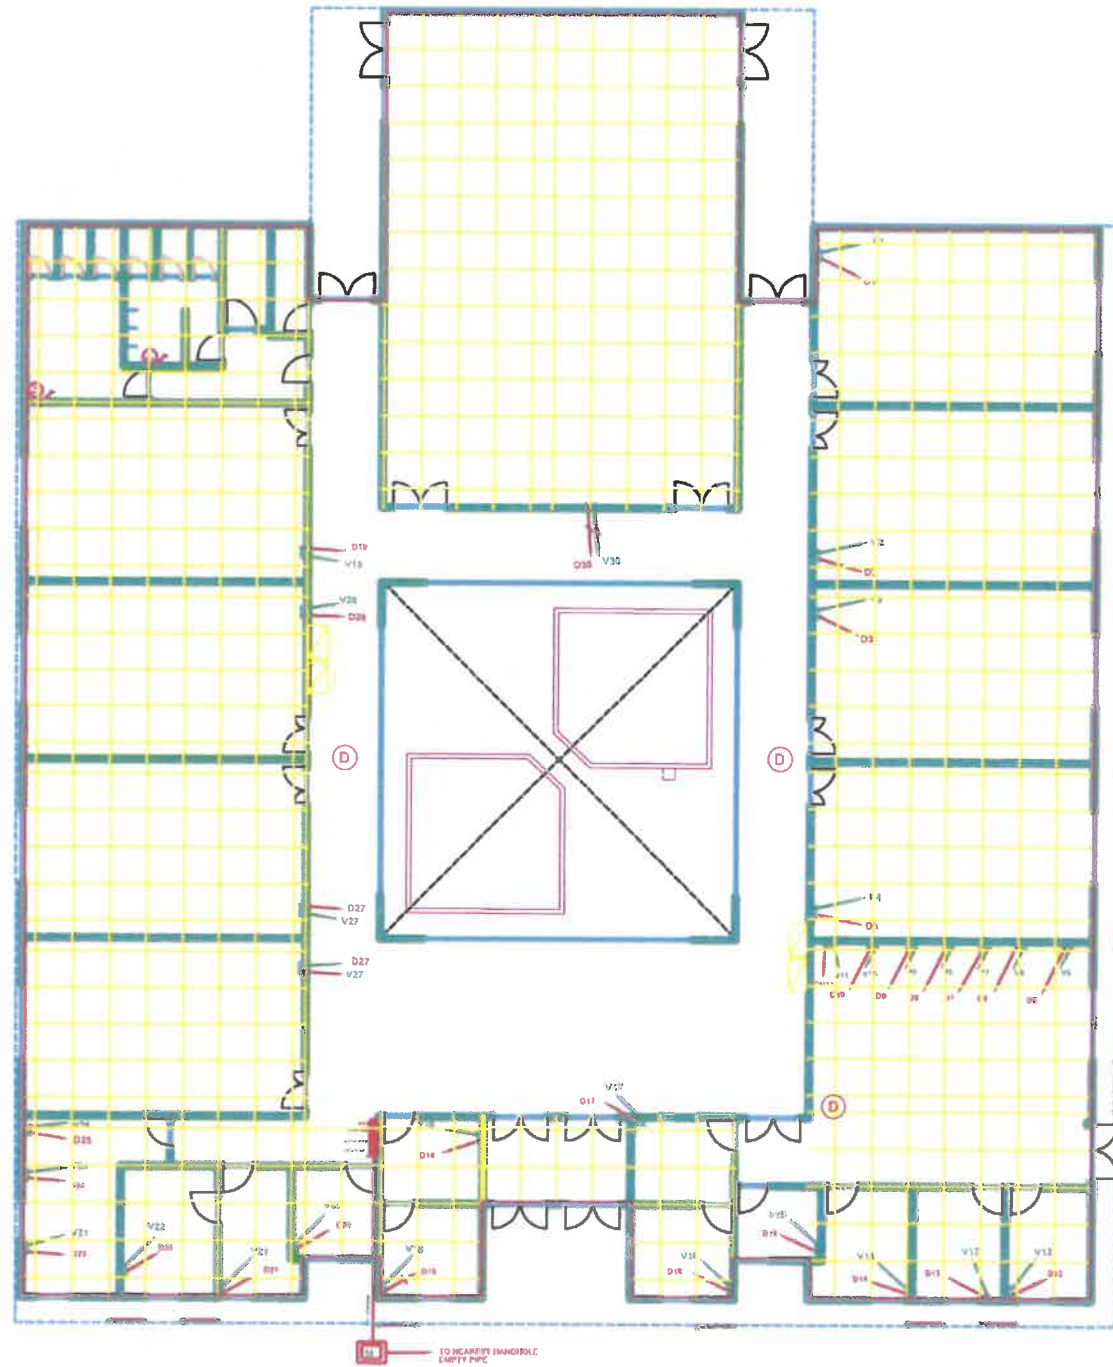


Client
GJU
 الجامعة الأردنية
 Gardenia Jordanian University
 Consultant
 Gardenia Jordanian University
 AMMAN - JORDAN

As Built - Prefab D



Scale
 N.T.S



E02

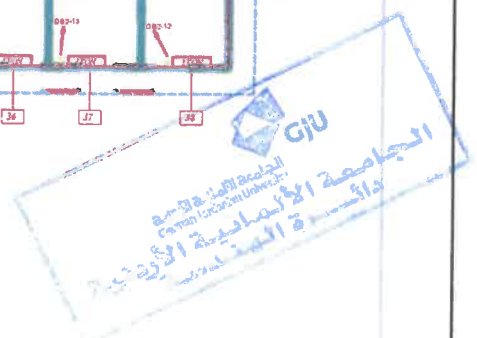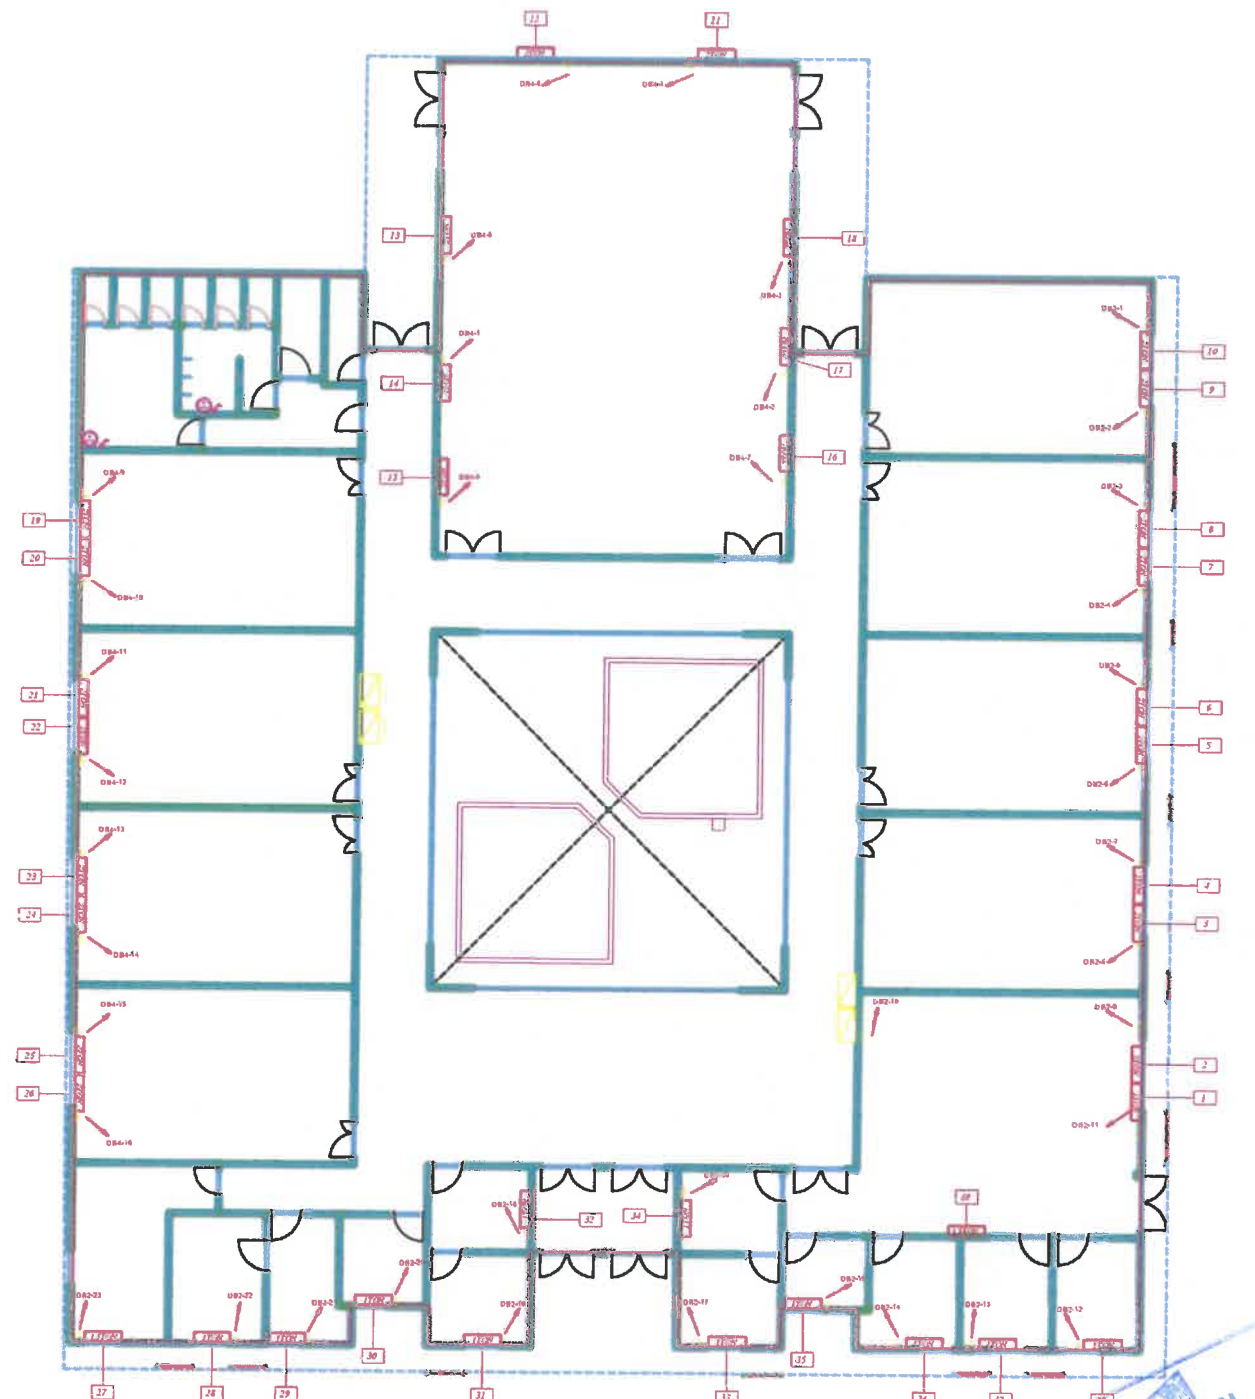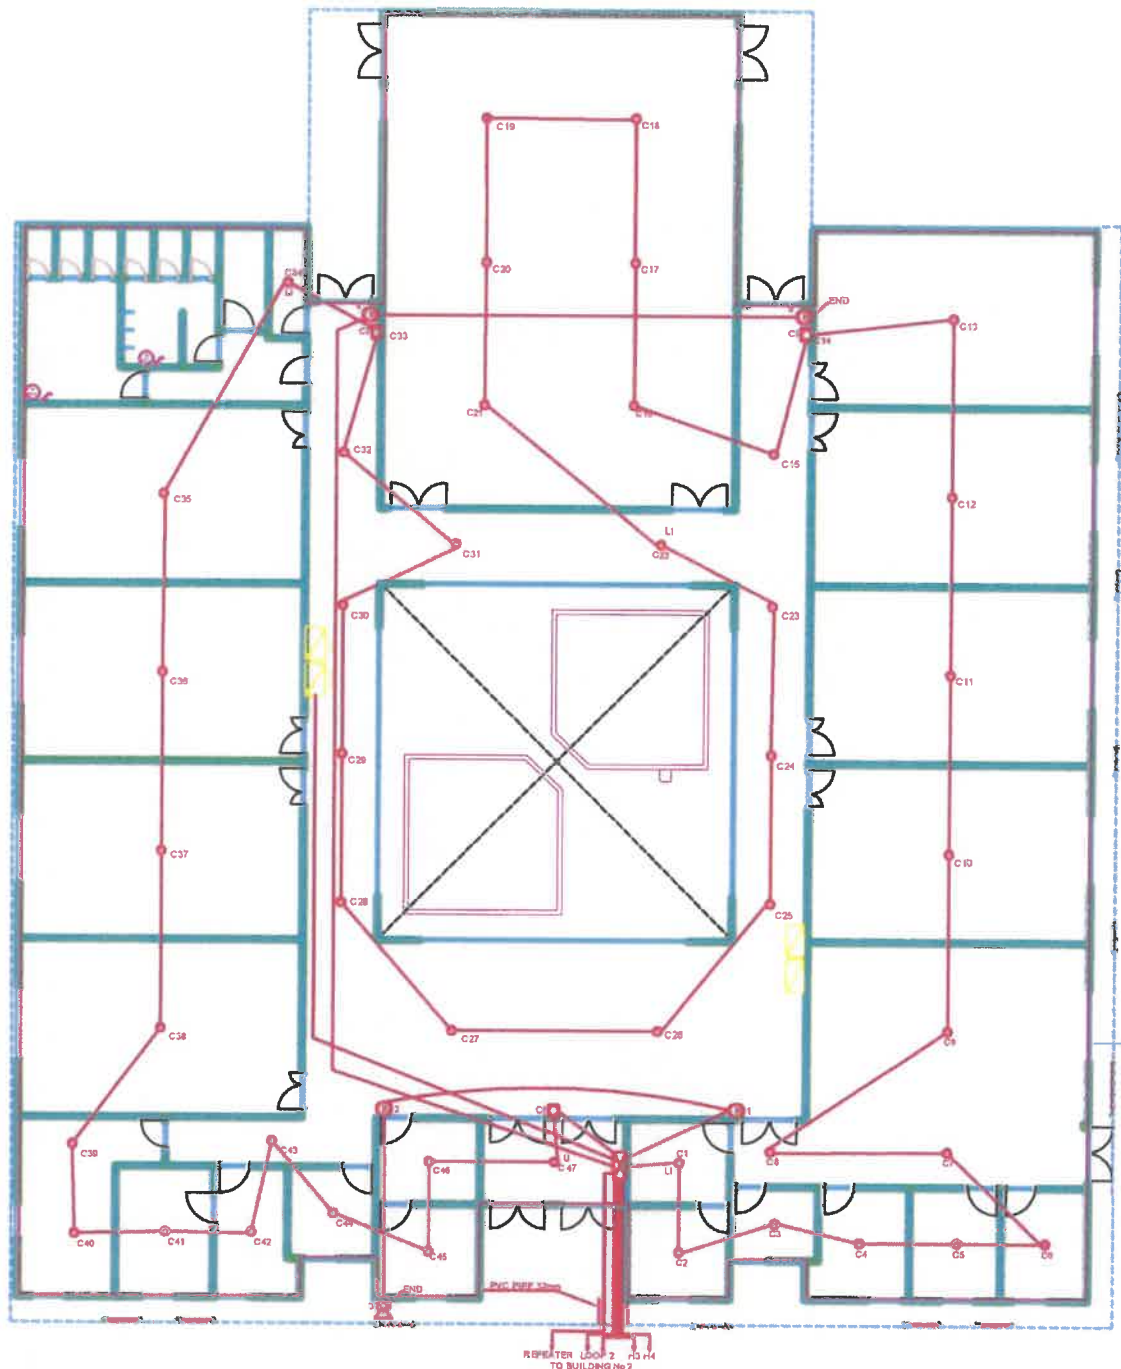

Client
GJU
 Client
Gardenia Jordanian University
AMMAN - JORDAN


As Built - Prefab D
 Scale
N.T.S
E03

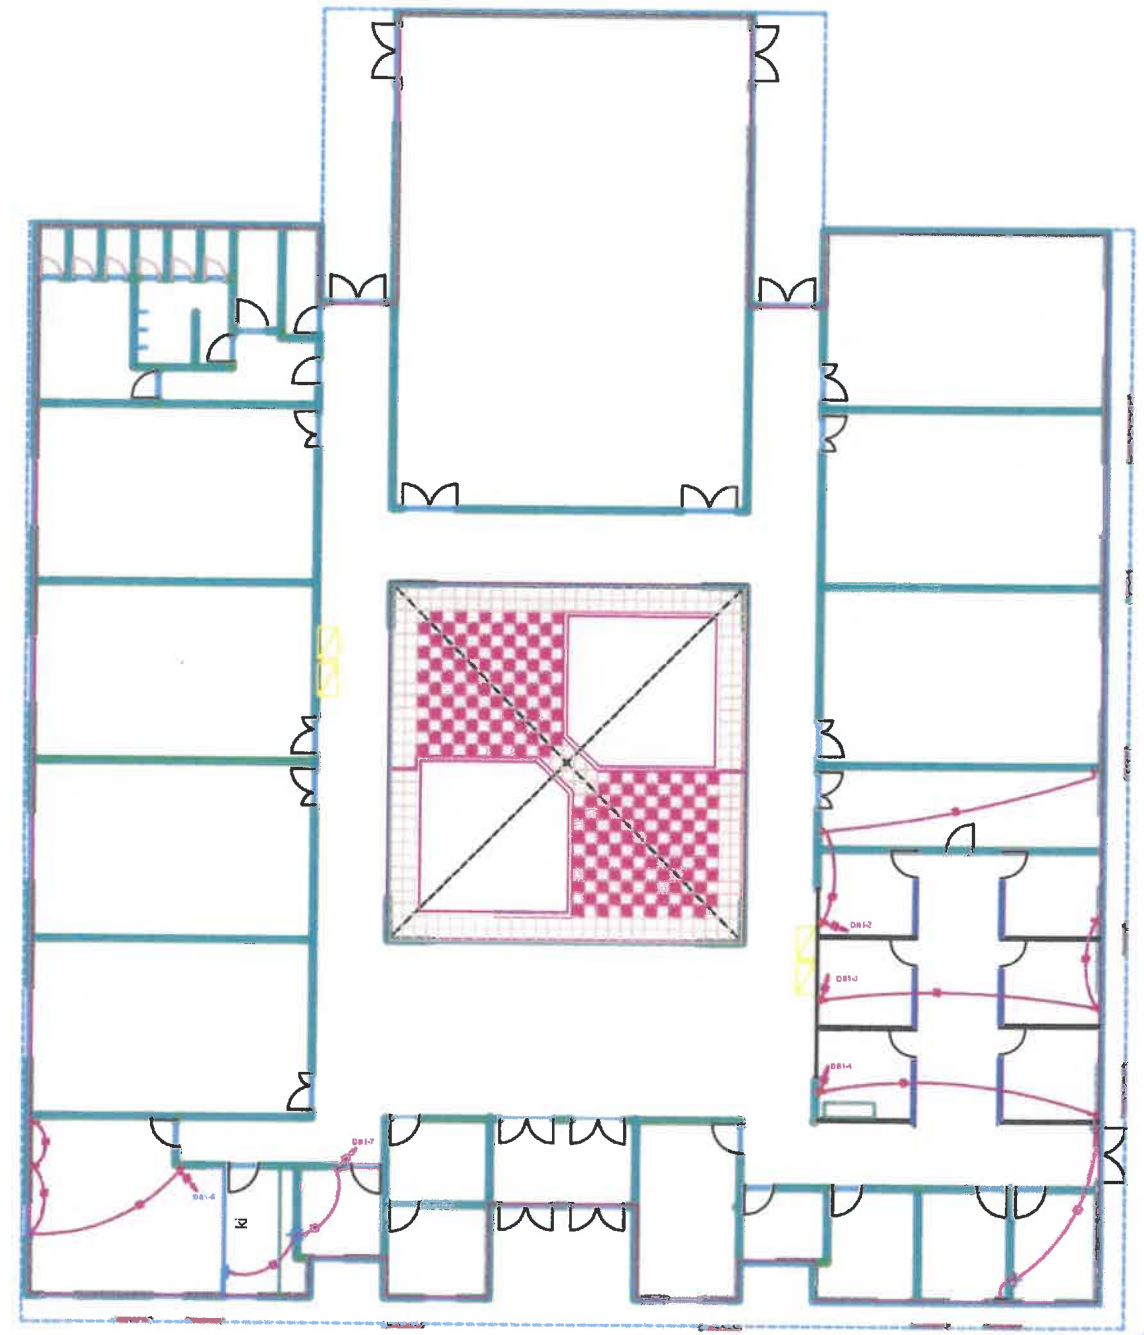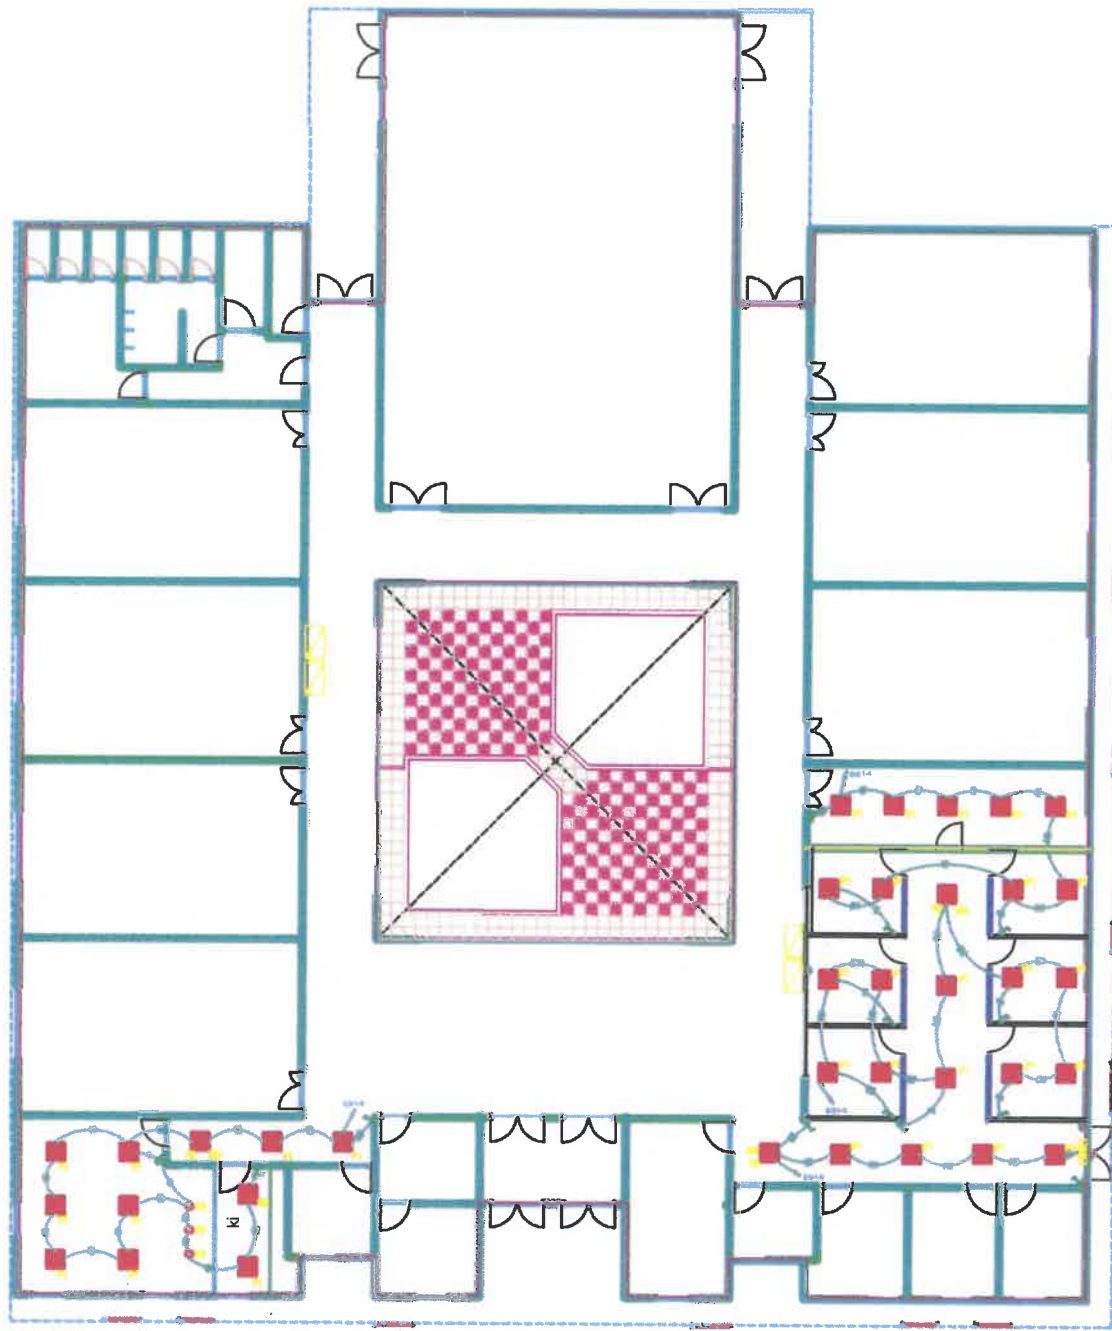

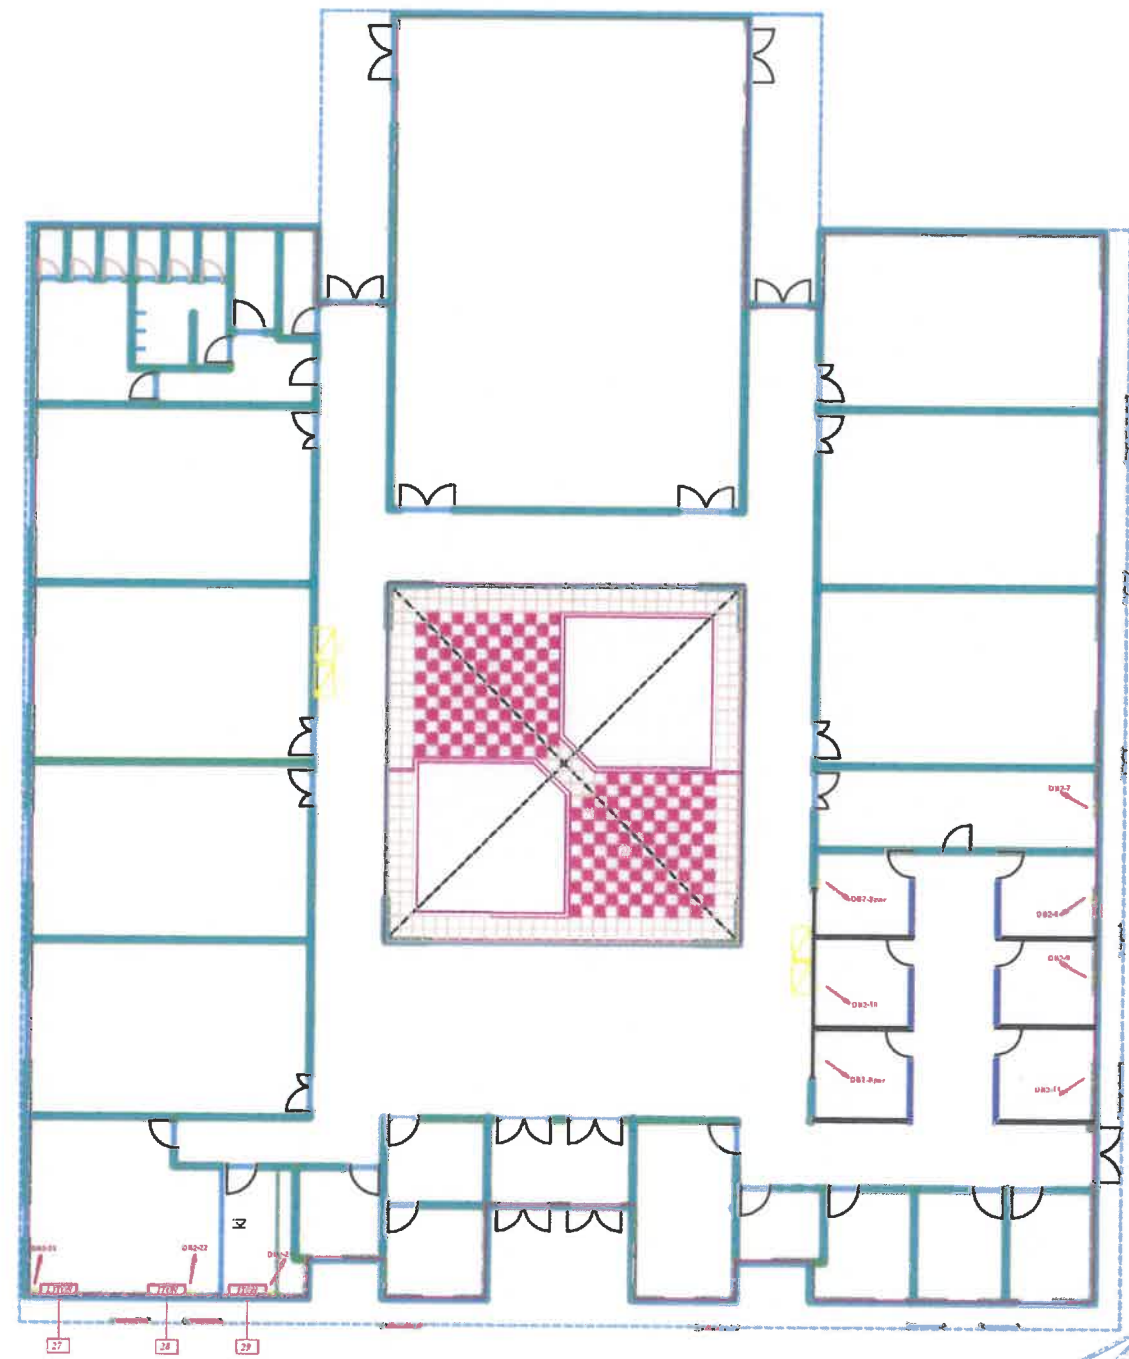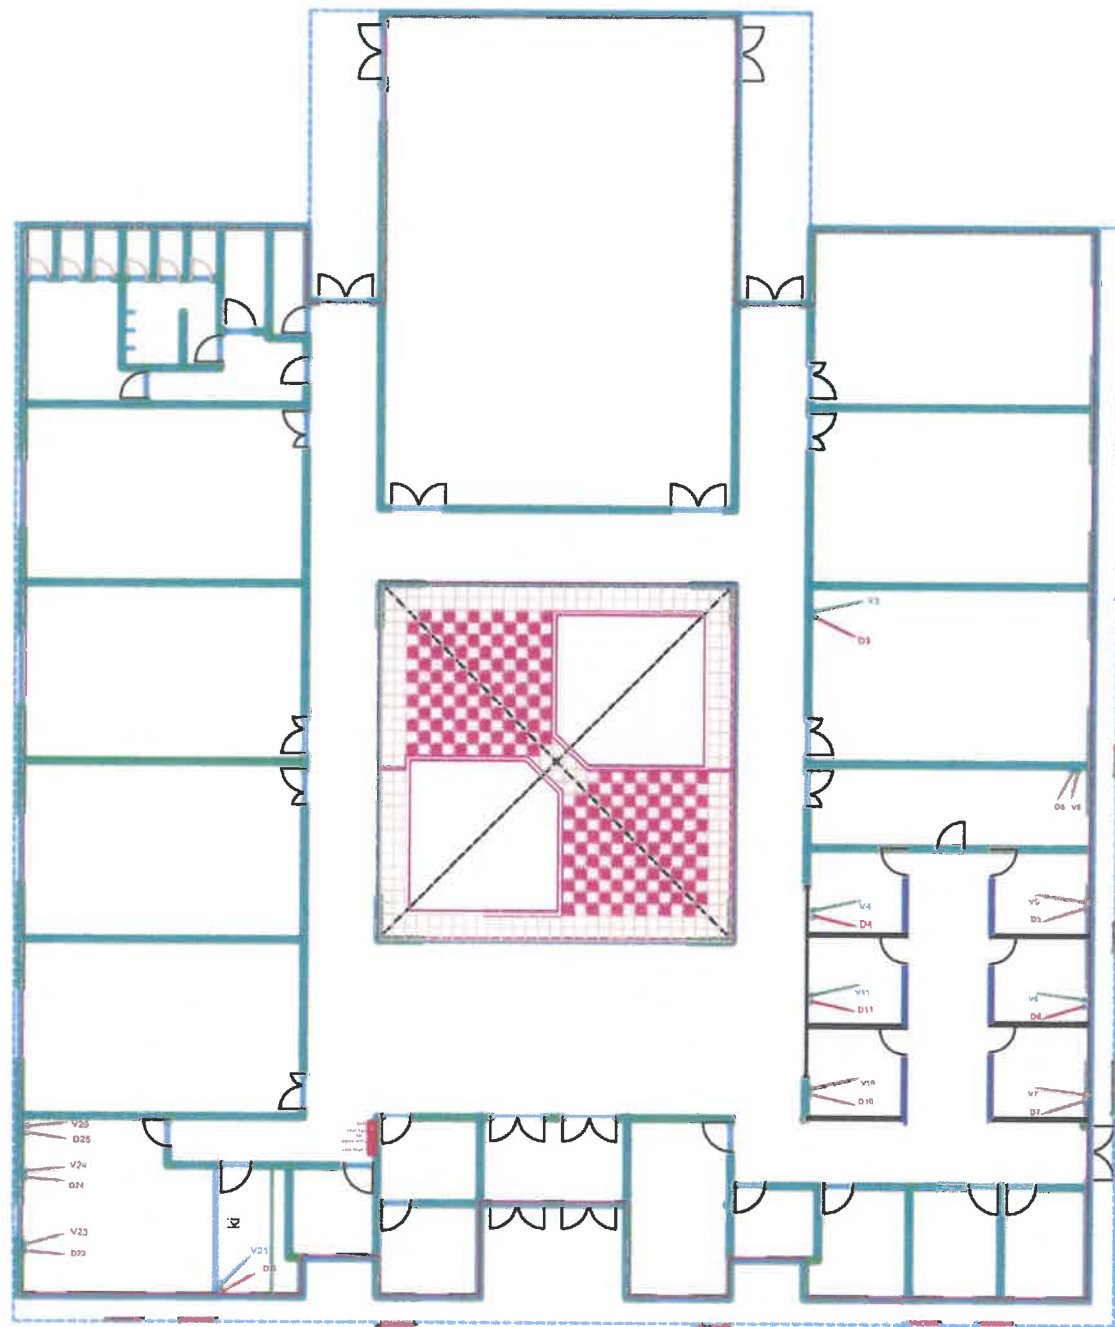

Client
GJU
 German Jordanian University
 AMMAN - JORDAN

NEW -Prefab D
 Scale
 N.T.S
 E05



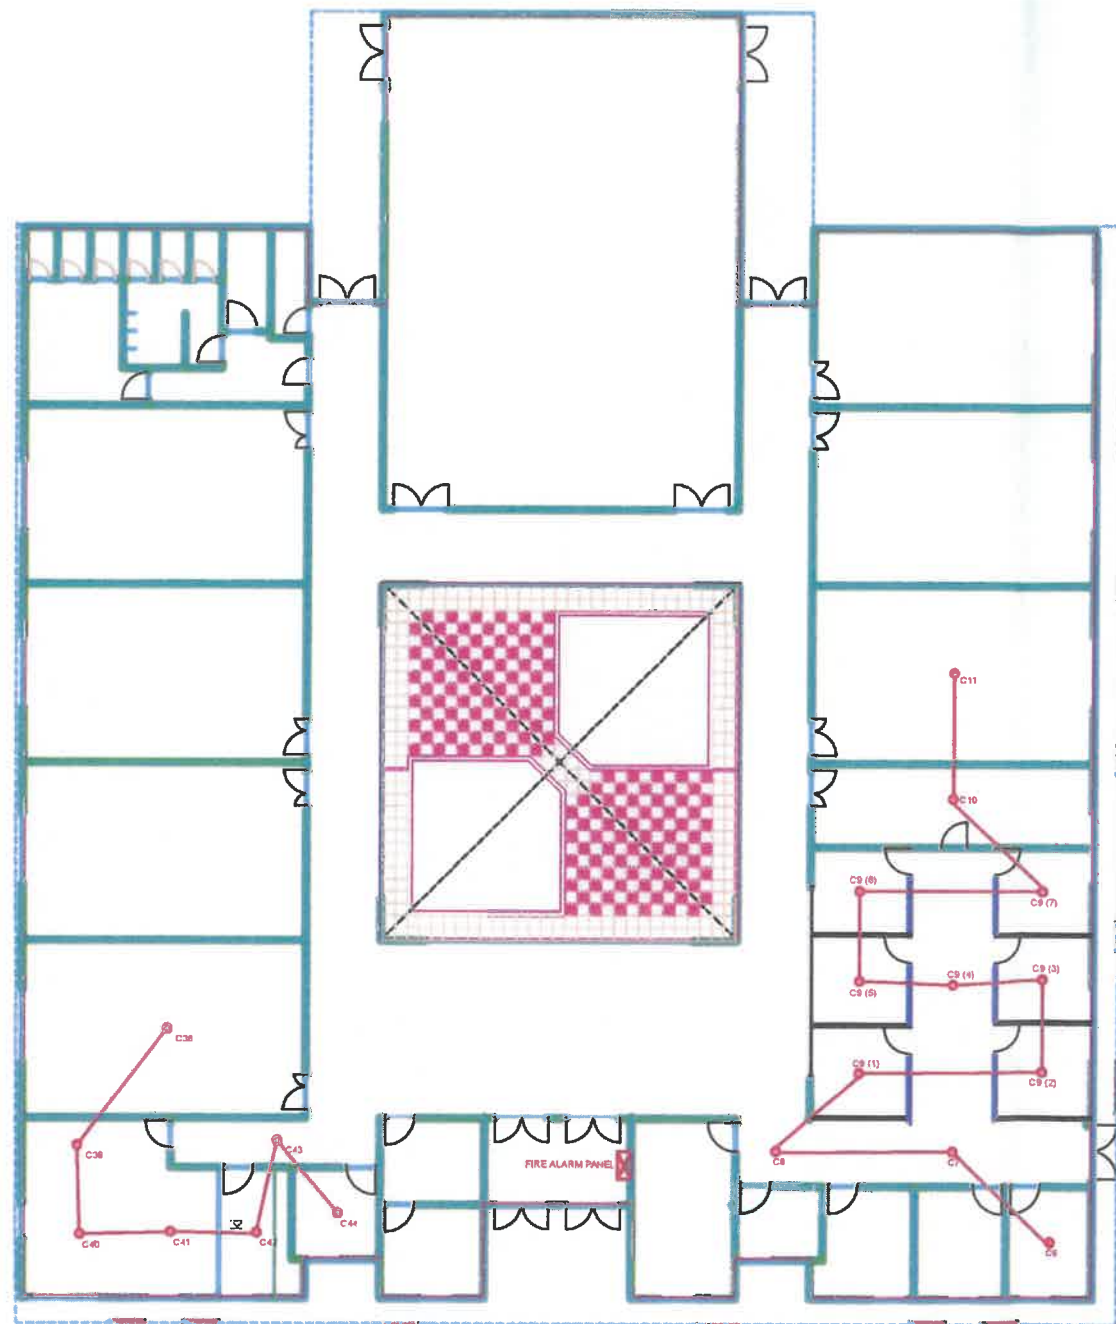


Client
GJU
 Gordan Jordanian University
 AMMAN - JORDAN

NEW -Prefab D

Scale
 N.T.S

E06

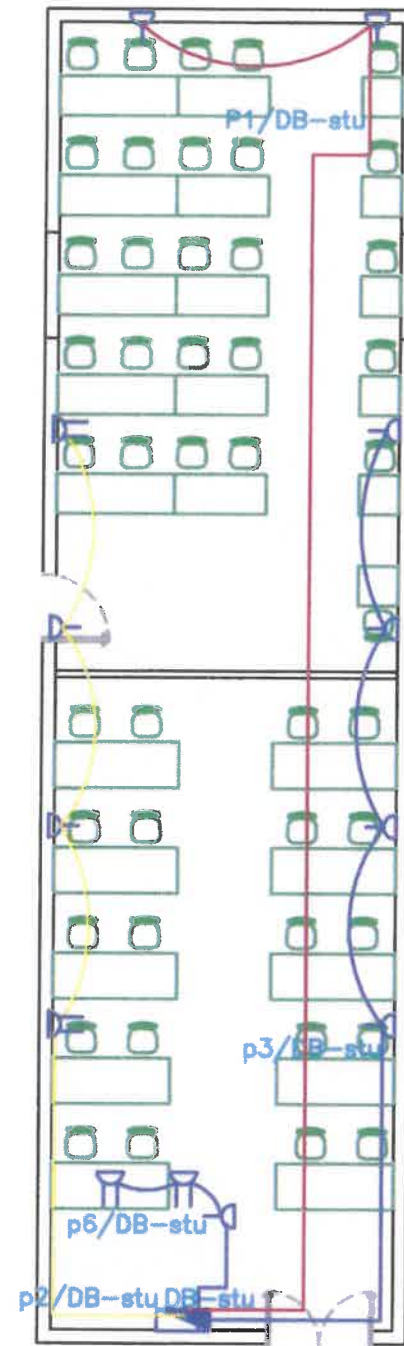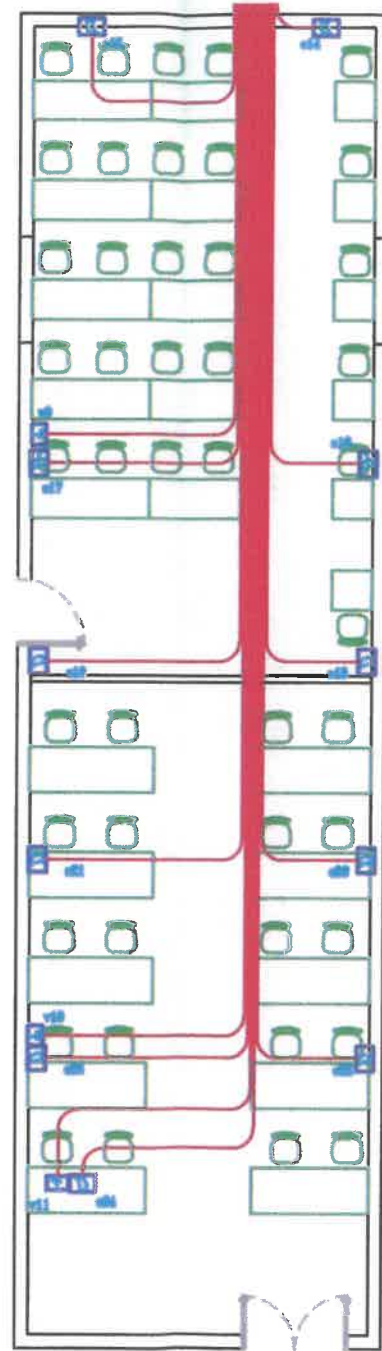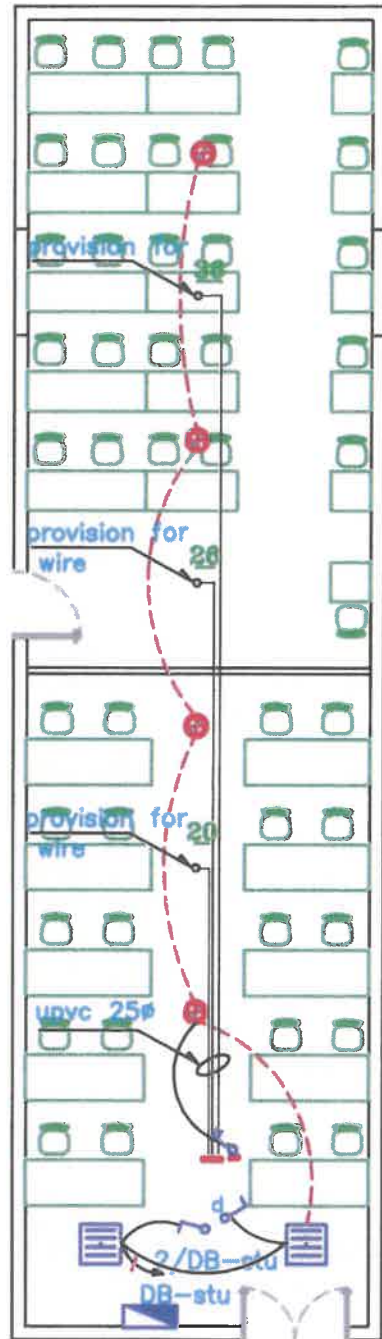

- P1/DB-stu(2)
- P2/DB-stu(6)
- P3/DB-stu(4)
- P6/DB-stu(5)





Client
GJU
 Gaza University
 AMMAN - JORDAN

Consultant
 German Jordanian
 University
 AMMAN - JORDAN

As built -Computer lab H

Scale
 N.T.S



E07

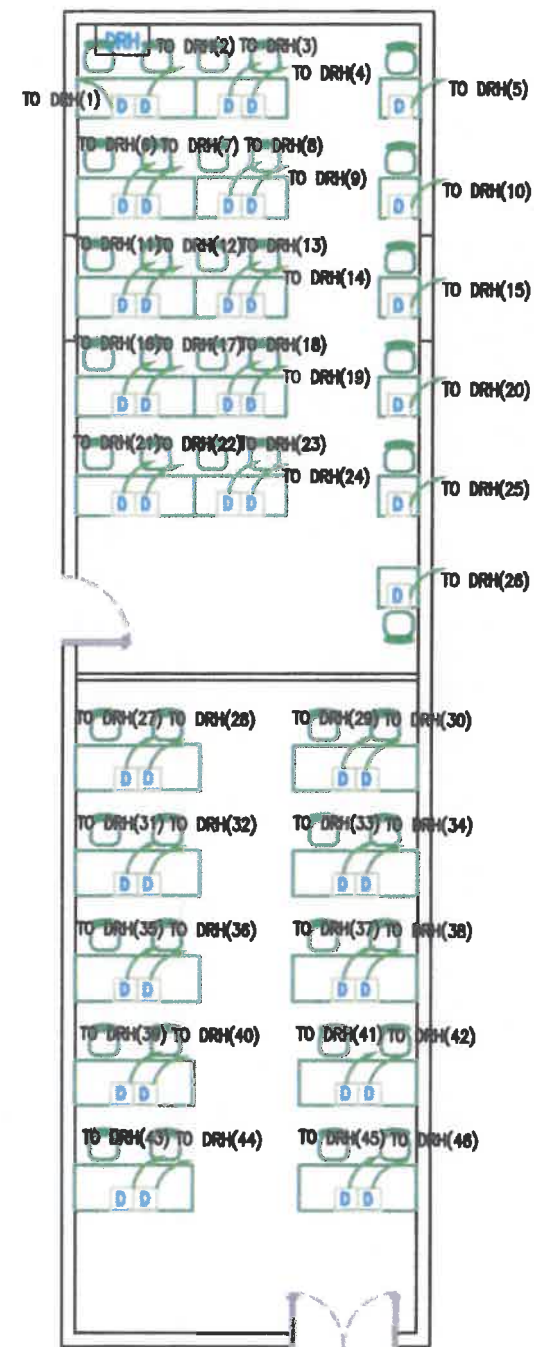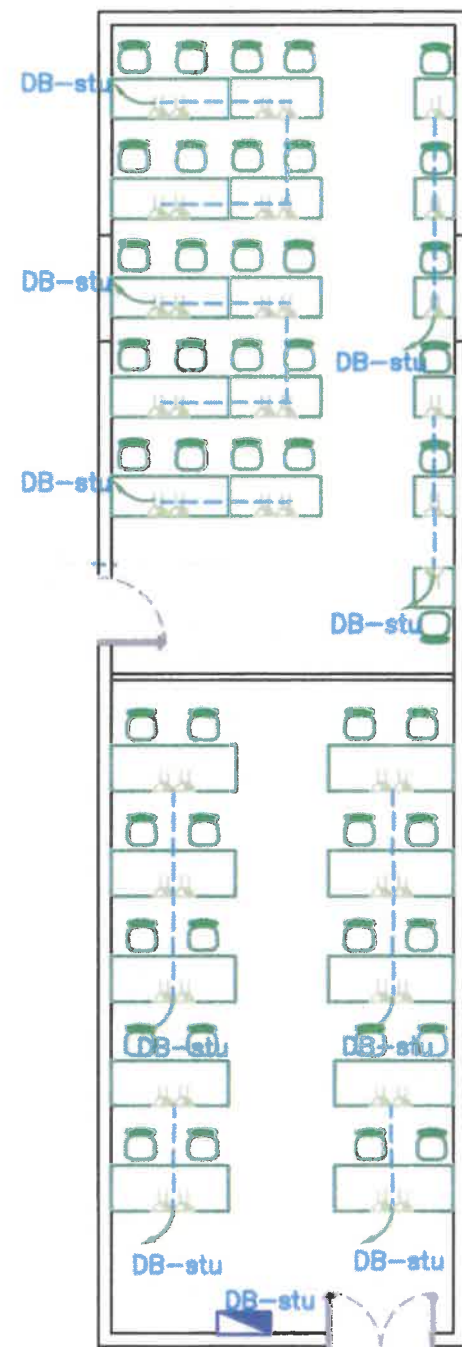

Client
GJU
 German Jordanian University
 AMMAN - JORDAN

NEW -Computer lab H
 Scale
 N.T.S
 E08

8 CORE MM FIBER OPTIC CABLE
LAID ON CABLE TRAY TO MAIN
DATA RACK IN BUILDING (L)

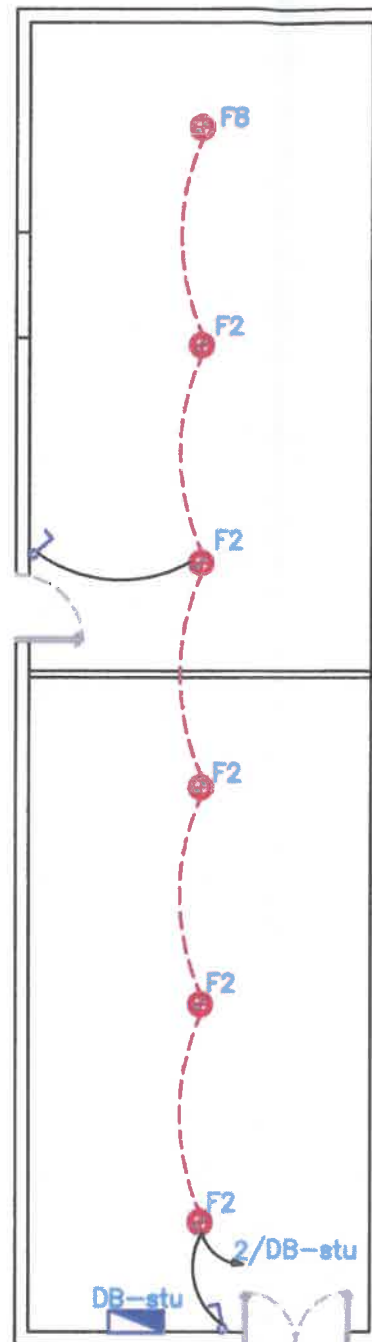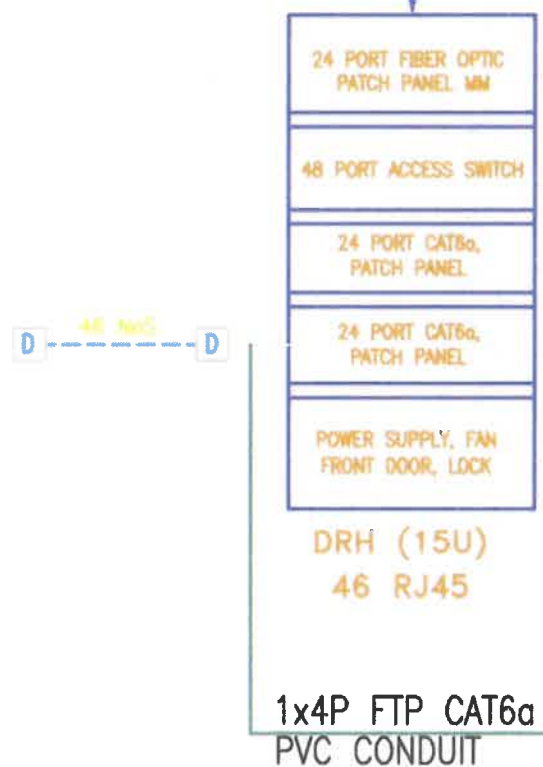

LIGHTING FIXTURE SCHEDULE

SYMBOL	FIX. REF.	VOLTS	WATTS	DESCRIPTION	NO.
⊕	F2	230	70W	SURFACE MOUNTED DOWNLIGHT WITH LED LAMP TYPE OF PROTECTION :IP 65 HOUSING: IN DIE-CAST ALUMINIUM WITH COOLING FINS. OPTICS: HIGH TEMPERATURE RESISTANCE AND UV RAYS. DIFFUSER: 4mm TEMPERED GLASS. PRODUCT WITH A VERY LOW FLICKER, POWER FACTOR>0.95 LUMINOUS FLUX MAINTENANCE 80.000h LUMEN OUTPUT 4000K-10263lm-CRI 80	6



Coordinator
Jordanian
University
AMMAN - JORDAN

NEW -Computer lab H

Scale
N.T.S

E09



Client
GJU
 German Jordanian University
 AMMAN - JORDAN

NEW -BUILDING B
 Scale
 N.T.S
 E11



Client
 Consultant
GJU
 German Jordanian
 University
 AMMAN - JORDAN

NEW -BUILDING B
 Scale
 N.T.S
 E12

